


(1) TIM FALLON LAND SURVEYING IS NOT RESPONSIBLE FOR PLACING A PROPOSED BUILDING IN AN EXISTING EASEMENT DUE TO THE FOLLOWING CRITERIA:
 (A) TIM FALLON LAND SURVEYING HAS NOT BEEN FURNISHED, BY THE CLIENT, WITH A CURRENT TITLE REPORT SHOWING EASEMENTS ON THE SITE.
 (B) TIM FALLON LAND SURVEYING HAS NOT PERFORMED RESEARCH TO DETERMINE THE EXISTENCE OF EASEMENTS ON THE SITE.
 (2) AFTER BUILDING PERMIT IS ISSUED, TIM FALLON LAND SURVEYING ASSUMES THAT THE BUILDER APPROVES THE LOCATIONS OF THE BUILDING SHOWN.
 (3) LOT IS SERVED BY CITY SEWER AND WATER.
 (4) LOT GRADING SHOWN HEREON IS IN ACCORDANCE WITH APPROVED SUBDIVISION PLAN.
 (5) ALL DIMENSIONS SHOWN ON THE BUILDING(S) ON THIS PLAN ARE FIELD STAKE-OUT DIMENSIONS AND HAVE BEEN VERIFIED BY THE BUILDER.
 (6) ALL TREES (IF ANY) SHOWN ON THIS PLAN WILL BE PROTECTED AND/OR PLANTED ACCORDING TO THE SUFFOLK LANDSCAPE SPECIFICATIONS MANUAL.
 (7) TIM FALLON LAND SURVEYING, PLLC IS ONLY RESPONSIBLE FOR ESTABLISHING TITLE LINES AND SETBACKS BASED ON ZONING ORDINANCE. NO OTHER HISTORY (I.E. OWNERSHIP AND CONFORMITY) WILL BE RESEARCHED. PLEASE CONTACT YOUR LOCAL MUNICIPALITY IN QUESTION TO ENSURE THE LOT IS BUILDABLE.

THE PROPERTY ENCOMPASSED BY THIS SUBDIVISION APPEARS TO LIE IN FLOOD ZONE 'X', AREA OF MINIMAL FLOOD HAZARD, AS SHOWN ON COMMUNITY PANEL NO. 5101560114E, DATED 08-03-2015.
 THE LOT GRADING METHOD IS A


NOTE: CONTRACTOR TO PERFORM ALL GRADING TO ENSURE POSITIVE DRAINAGE.
 NOTE: GRADES FOR CURB, PAVEMENT AND STRUCTURES WITHIN THE ROAD ARE PER APPROVED SITE PLAN. CONTRACTOR TO COORDINATE GRADES WITH AS-BUILT CONDITIONS.

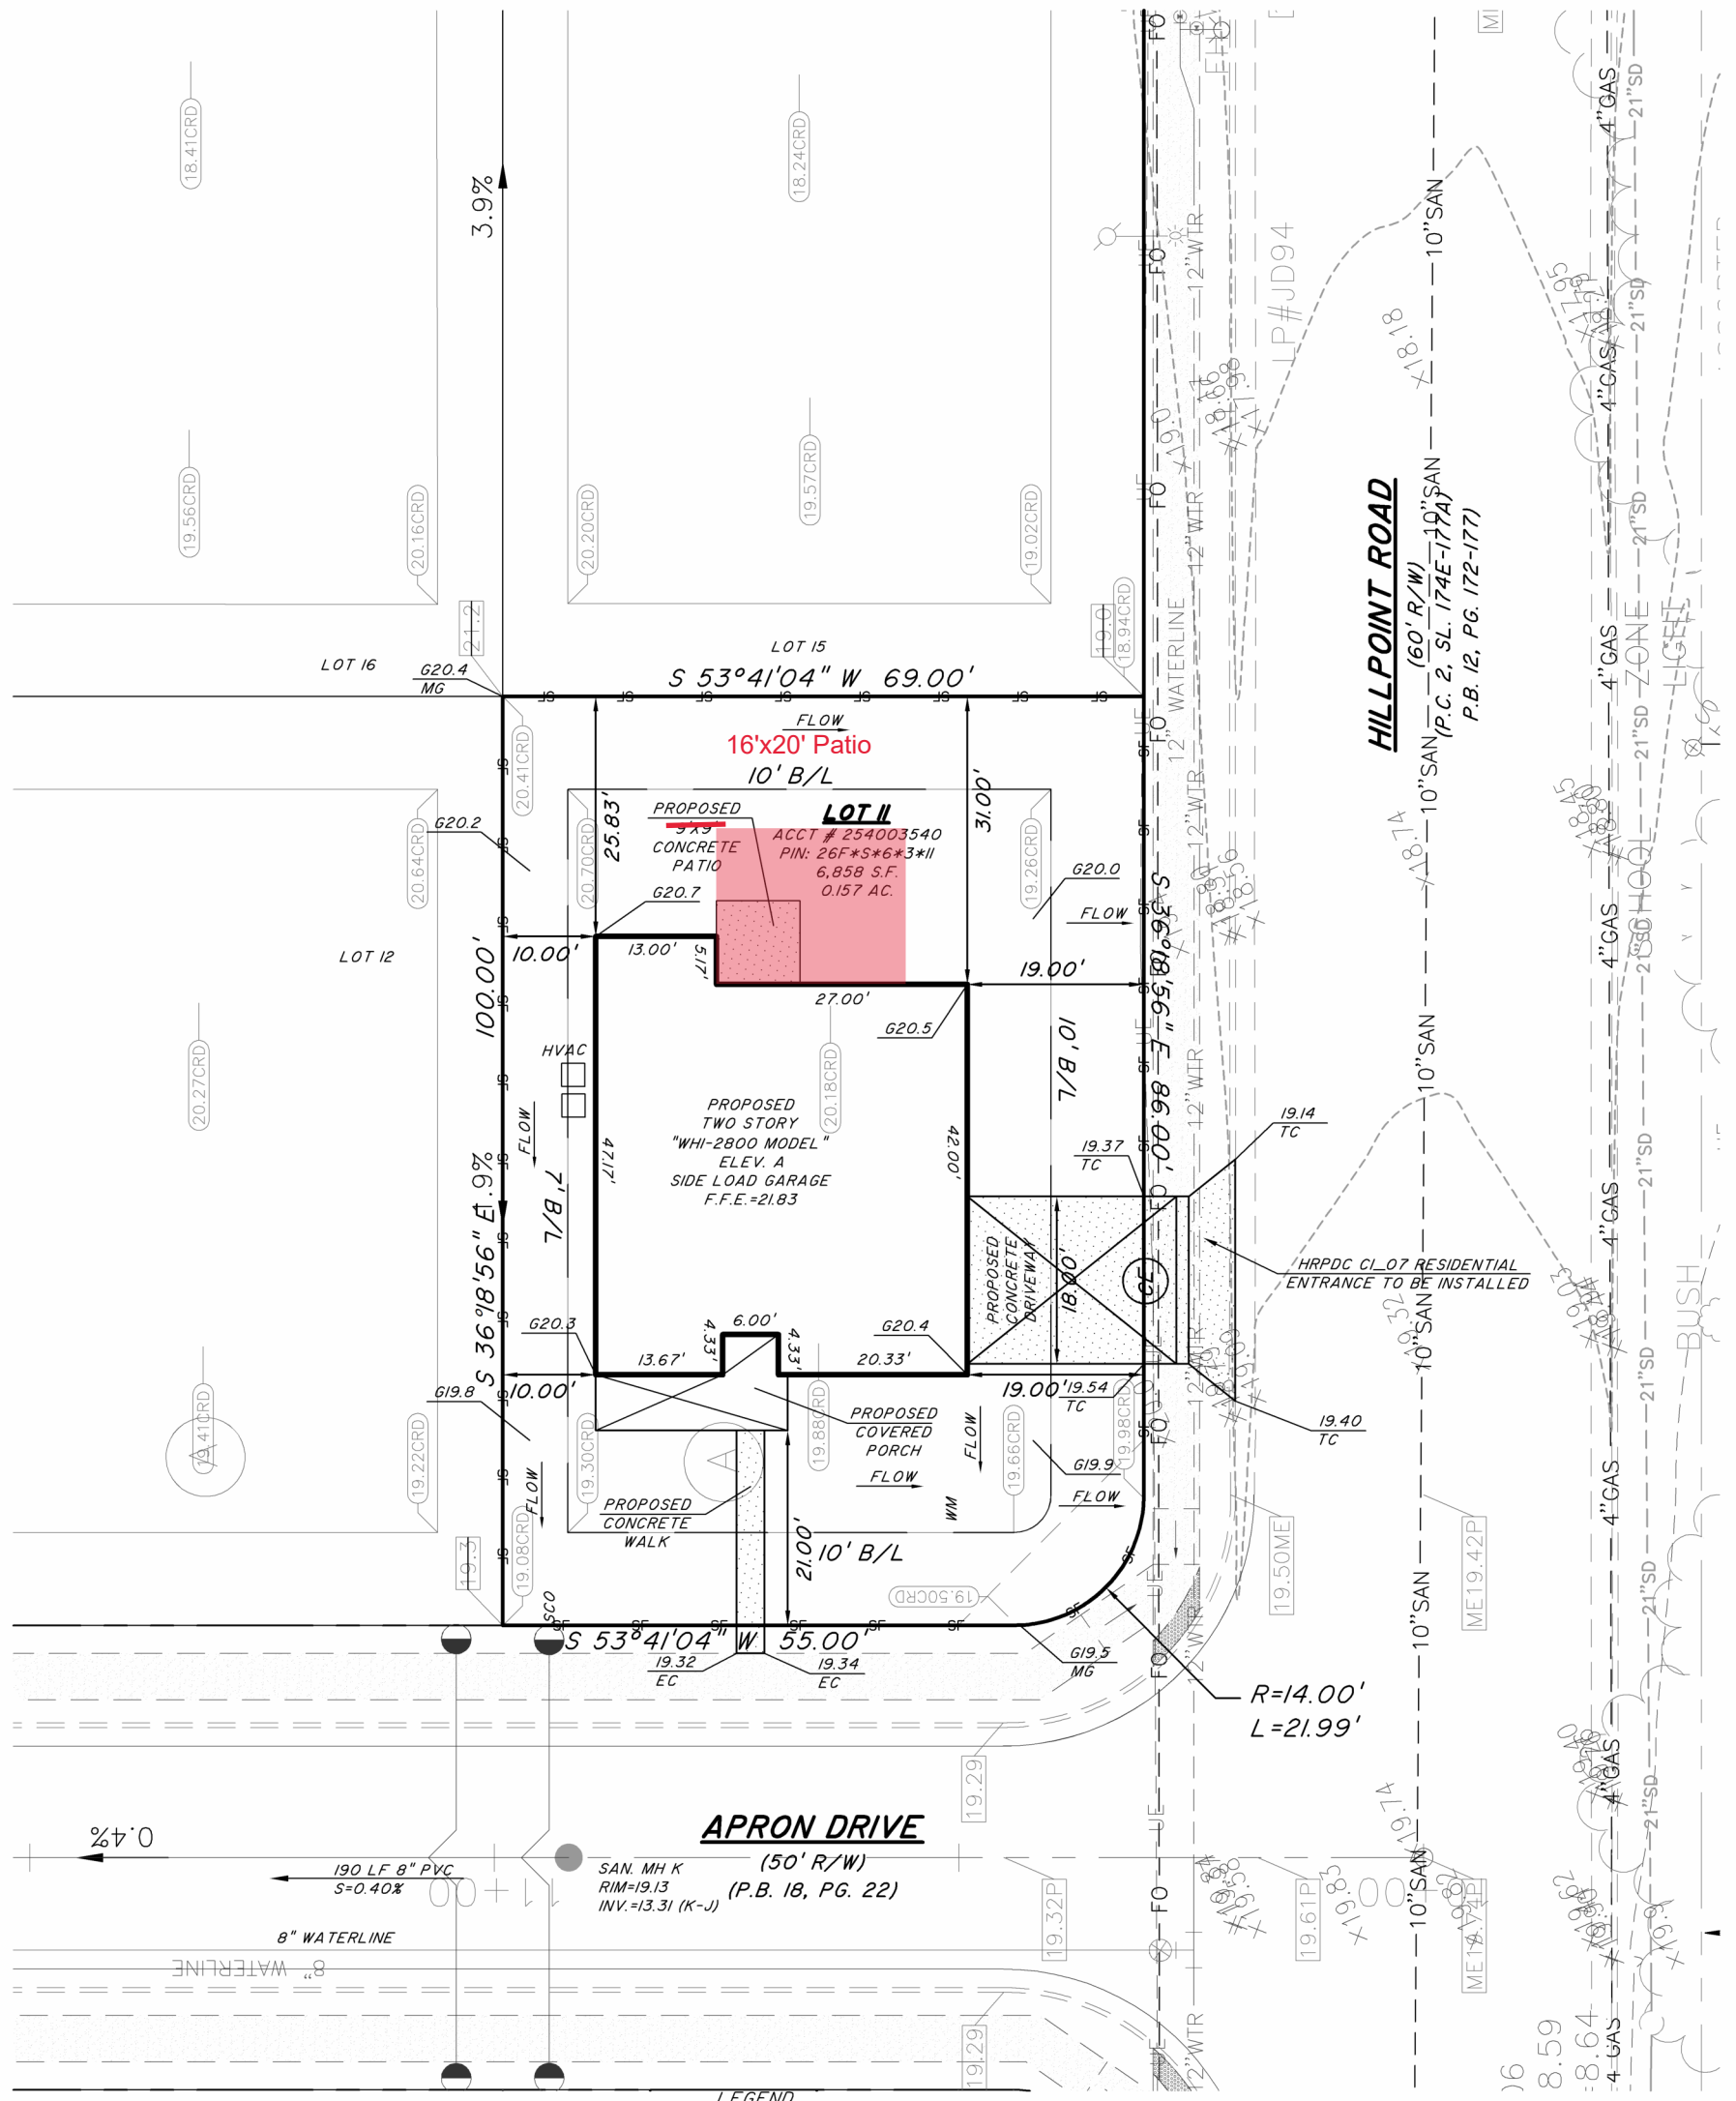

- LEGEND**
- SF — (SF) = SILT FENCE
 - (IP) = INLET PROTECTION
 - (CE) = CONSTRUCTION ENTRANCE
 - (XX.XXCRD) = CONSTRUCTION RECORD DRAWING ELEVATION

TAX ACC#254003540
 TAX PARCEL#26F*S*6*3*11
 ROADSIDE DITCH/SWALE TO BE REGRADED TO ENSURE POSITIVE DRAINAGE
 LOT GRADING METHOD TO BE A
 PLAT REFERENCE: INSTR # 240001617,
 INSTR # 250003004
 DATE: 07-15-2025
 DRAWN BY: BSG
 JOB # 24263 - II-WHI-2800

IMPERVIOUS AREA	
LOT AREA	= 6,858 SQ. FT.
HOUSE/GARAGE	= 1,721 SQ. FT.
CONCRETE DRIVE/WALK	= 593 SQ. FT.
DECK/PATIO	= 231 SQ. FT.
HVAC PAD	= 6 SQ. FT.
TOTAL IMPERVIOUS	= 2,551 SQ. FT.
PERCENT IMPERVIOUS	= 37.19 %

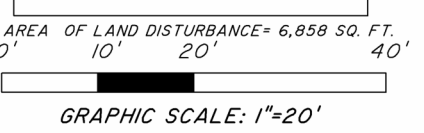

SITE PLAN OF LOT II
NRGC SUBDIVISION-PHASE 2
CHUCKATUCK BOROUGH
SUFFOLK, VIRGINIA
 TIM FALLON LAND SURVEYING, PLLC
 15139 CARROLLTON BLVD,
 SUITE C, P.O. BOX 189
 CARROLLTON, VIRGINIA, 23314